


250 HUDSON STREET

HUDSON SQUARE DISTRICT

Entire 6th floor | As-Built | 27,761 SF

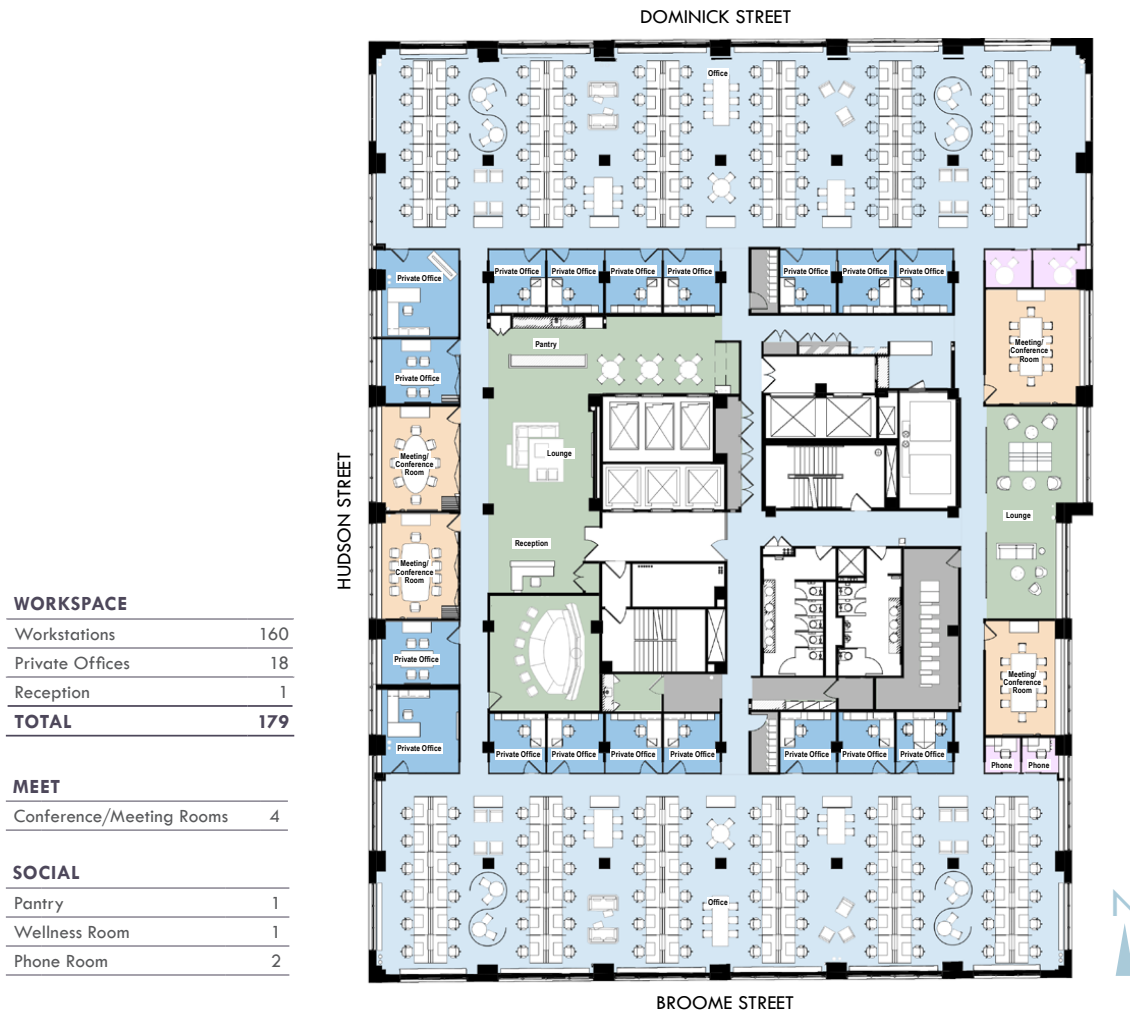

WORKSPACE	
Workstations	160
Private Offices	18
Reception	1
TOTAL	179

MEET	
Conference/Meeting Rooms	4

SOCIAL	
Pantry	1
Wellness Room	1
Phone Room	2



Jack Resnick & Sons
Owners & Builders Since 1928



 Jack Resnick & Sons
Owners & Builders Since 1928

110 East 59 Street
New York, NY 10022-1379
resnicknyc.com

Adam S. Rappaport
646.253.3111
arappaport@resnicknyc.com

Brett S. Greenberg
646.253.3113
bgreenberg@resnicknyc.com



No warranty or representation, express or implied, is made as to the accuracy of the information contained herein, and same is submitted subject to errors, omissions, change of price, rental other conditions, withdrawal without notice, and to any special listing conditions, imposed by our principals.