
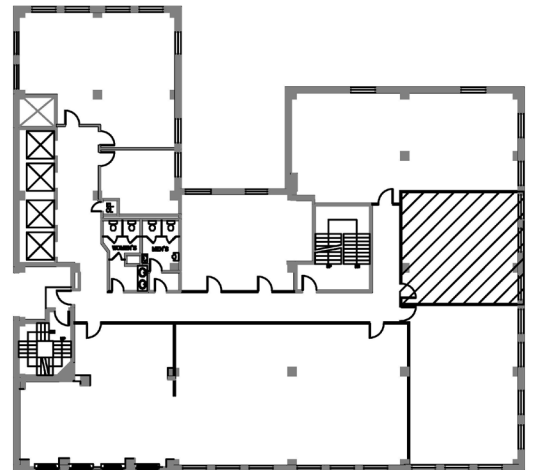


**133 EAST 58 STREET**

**PLAZA DISTRICT**

**Partial 3rd Floor | Suite 307 | As-Built | 985 SF**

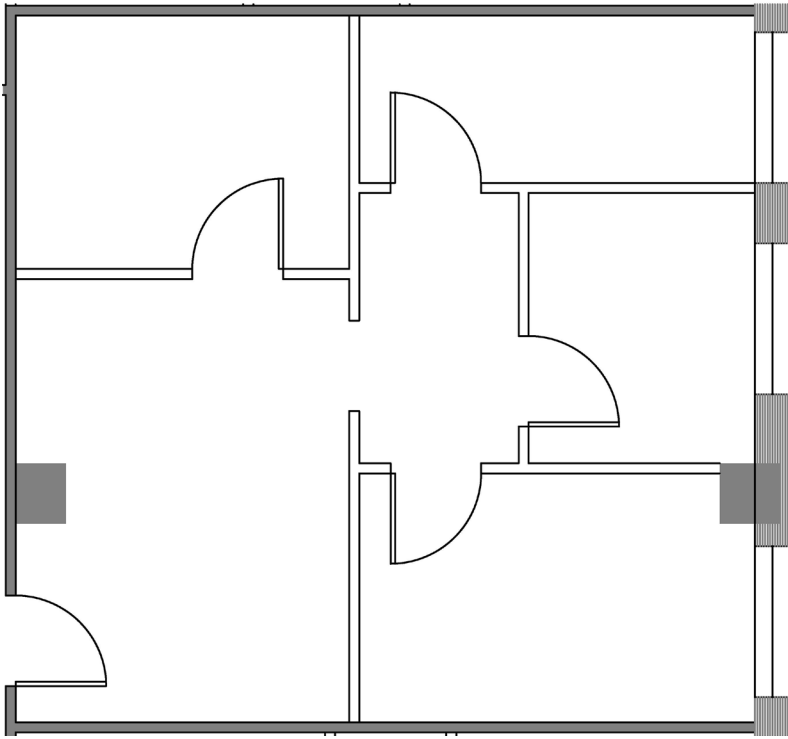

Jack Resnick & Sons  
*Owners & Builders Since 1928*

110 East 59 Street  
New York, NY 10022-1379  
resnicknyc.com

**Fran Delgorio**  
212.421.1300  
fdelgorio@resnicknyc.com

**Brett S. Greenberg**  
212.421.1300  
bgreenberg@resnicknyc.com



No warranty or representation, express or implied, is made as to the accuracy of the information contained herein, and same is submitted subject to errors, omissions, change of price, rental other conditions, withdrawal without notice, and to any special listing conditions, imposed by our principals.