
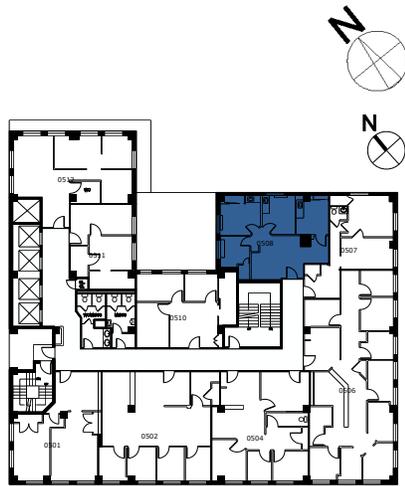


# 133 EAST 58 STREET

# MID TOWN EAST DISTRICT

## Partial 5th Floor | Suite 508 | As-Built | 1,112 SF

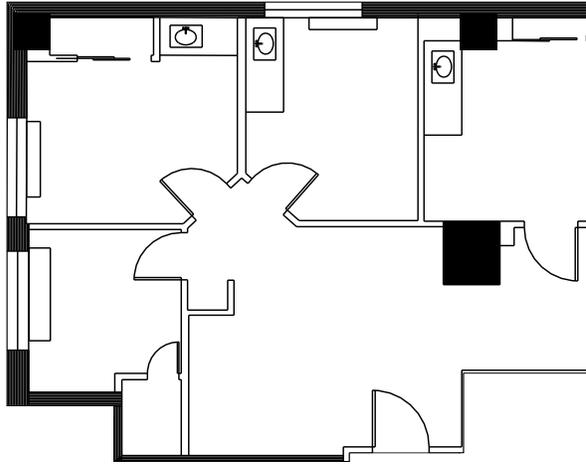

Key Plan - Not to scale



Jack Resnick & Sons  
Owners & Builders Since 1928

110 East 59 Street  
New York, NY 10022-1379  
resnicknyc.com

Fran Delgorio  
646.253.3100  
fdelgorio@resnicknyc.com

Brett S. Greenberg  
646.253.3113  
bgreenberg@resnicknyc.com



No warranty or representation, express or implied, is made as to the accuracy of the information contained herein, and same is submitted subject to errors, omissions, change of price, rental other conditions, withdrawal without notice, and to any special listing conditions, imposed by our principals.