

200 CHAMBERS STREET

TRIBECA DISTRICT

Retail | 8,450 SF



EXISTING CONDITIONS



Jack Resnick & Sons
Owners & Builders Since 1928

110 East 59 Street
New York, NY 10022-1379
resnicknyc.com

Fran Delgorio
646.253.3100
fdelgorio@resnicknyc.com


Brett S. Greenberg
646.253.3113
bgreenberg@resnicknyc.com

No warranty or representation, express or implied, is made as to the accuracy of the information contained herein, and same is submitted subject to errors, omissions, change of price, rental other conditions, withdrawal without notice, and to any special listing conditions, imposed by our principals.

200 CHAMBERS STREET

TRIBECA DISTRICT

Retail | As-Built | 8,450 SF

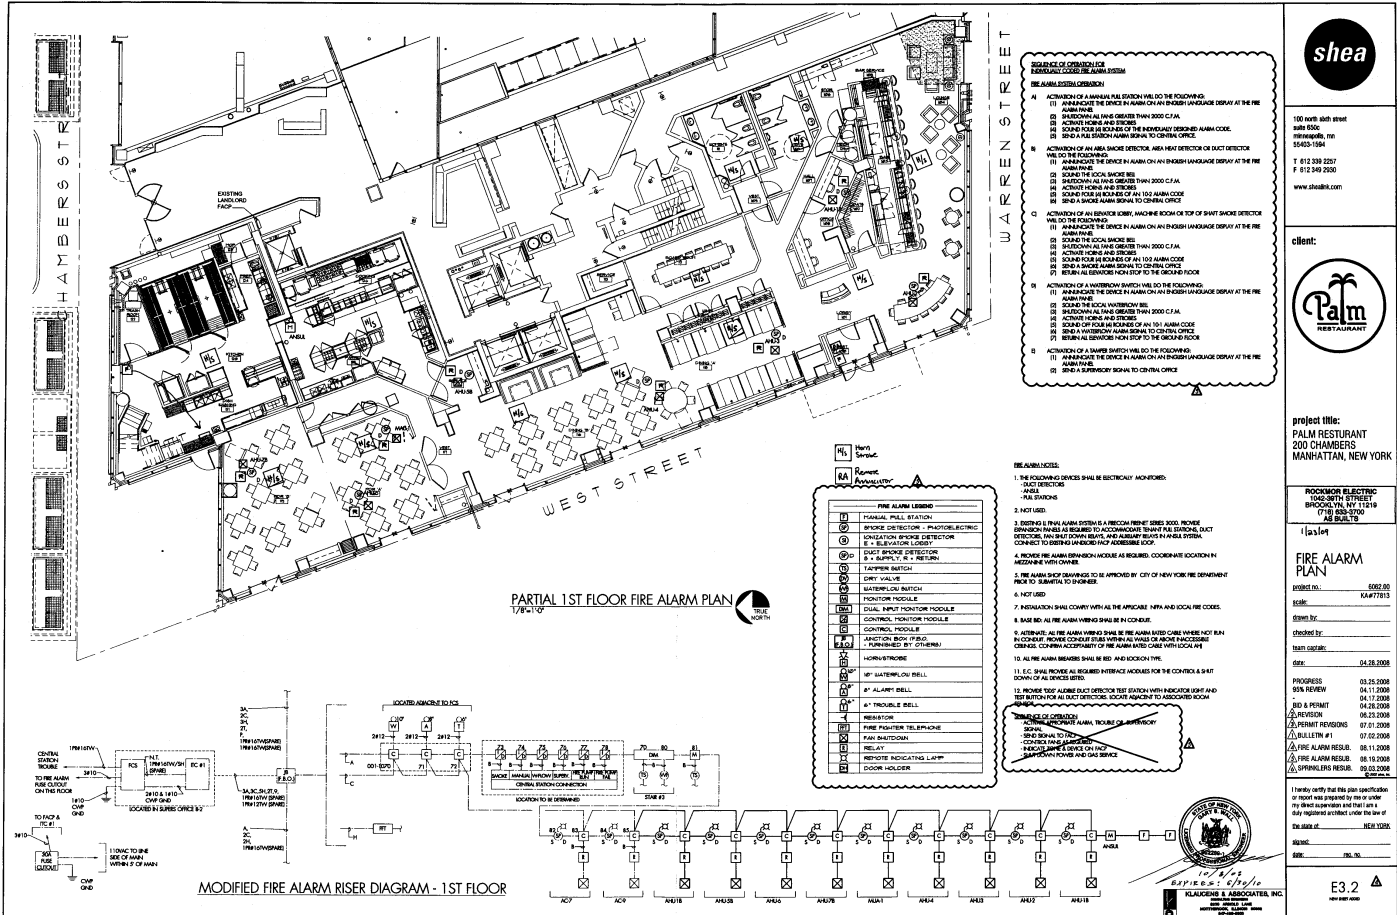

160 West 88th Street
 Suite 600
 New York, NY
 10024-1964
 T 612 339 2227
 F 612 349 2030
 www.sheainc.com

client:



project title:
 PALM RESTAURANT
 200 CHAMBERS STREET
 MANHATTAN, NEW YORK



ROCKWORTH ELECTRIC
 300 WEST 119th STREET
 BROOKLYN, NY 11219
 (718) 858-8200

DATE: 04.28.2008

PROGRESS: 04.26.2008
 SDR REVIEW: 04.11.2008
 RSD & PERMIT: 04.17.2008
 REVISION: 04.28.2008
 PERMIT REVISION: 07.01.2008
 BULLETIN #1: 07.02.2008
 FIRE ALARM REVISION: 08.11.2008
 FIRE ALARM REVISION: 09.19.2008
 SPRINKLER REVISION: 09.22.2008

DATE: 04.28.2008
 BY: [Signature]
 CHECKED BY: [Signature]
 TEAM LEADER: [Signature]

ES.2

Jack Resnick & Sons
 Owners & Builders Since 1928
 resnicknyc.com

110 East 59 Street
 New York, NY 10022-1379
 resnicknyc.com

Fran Delgorio
 646.253.3100
 fdelgorio@resnicknyc.com


Brett S. Greenberg
 646.253.3113
 bgreenberg@resnicknyc.com

No warranty or representation, express or implied, is made as to the accuracy of the information contained herein, and same is submitted subject to errors, omissions, change of price, rental other conditions, withdrawal without notice, and to any special listing conditions, imposed by our principals.

200 CHAMBERS STREET

TRIBECA DISTRICT

Mezzanine | As-Built | 2,191 SF

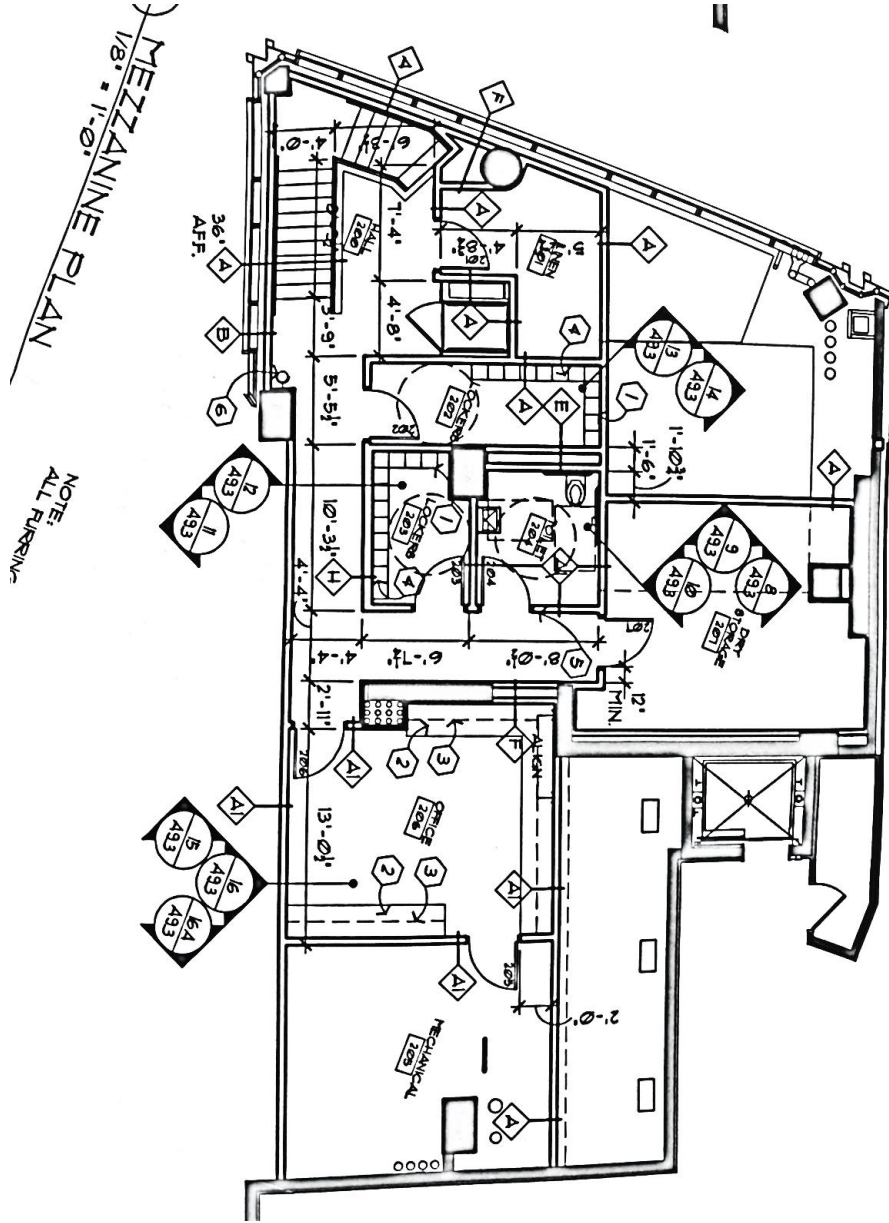

Jack Resnick & Sons
Owners & Builders Since 1928

110 East 59 Street
New York, NY 10022-1379
resnicknyc.com

Fran Delgorio
646.253.3100
fdelgorio@resnicknyc.com

Brett S. Greenberg
646.253.3113
bgreenberg@resnicknyc.com