
8 WEST 40 STREET

BRYANT PARK DISTRICT

Entire 12th Floor | As-Built | 6,667 SF

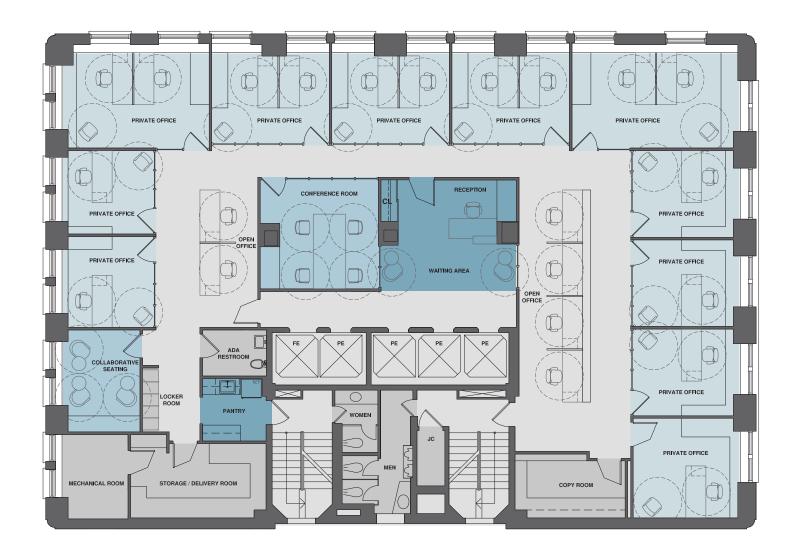

WORK PLACE	people
Private Office	16
Workstation	6
Total	22

1	3
1	3
areas	seats
	areas 1

Total Dedicated Desks	22 people
Total Collaborative Seats	
Open & Enclosed	10 people





110 East 59 Street New York, NY 10022-1379 resnicknyc.com Fran Delgorio 212.421.1300 fdelgorio@resnicknyc.com Brett S. Greenberg 212.421.1300 bgreenberg@resnicknyc.com