


# 255 Greenwich

## Entire 4<sup>th</sup> Floor | 51,953 SF

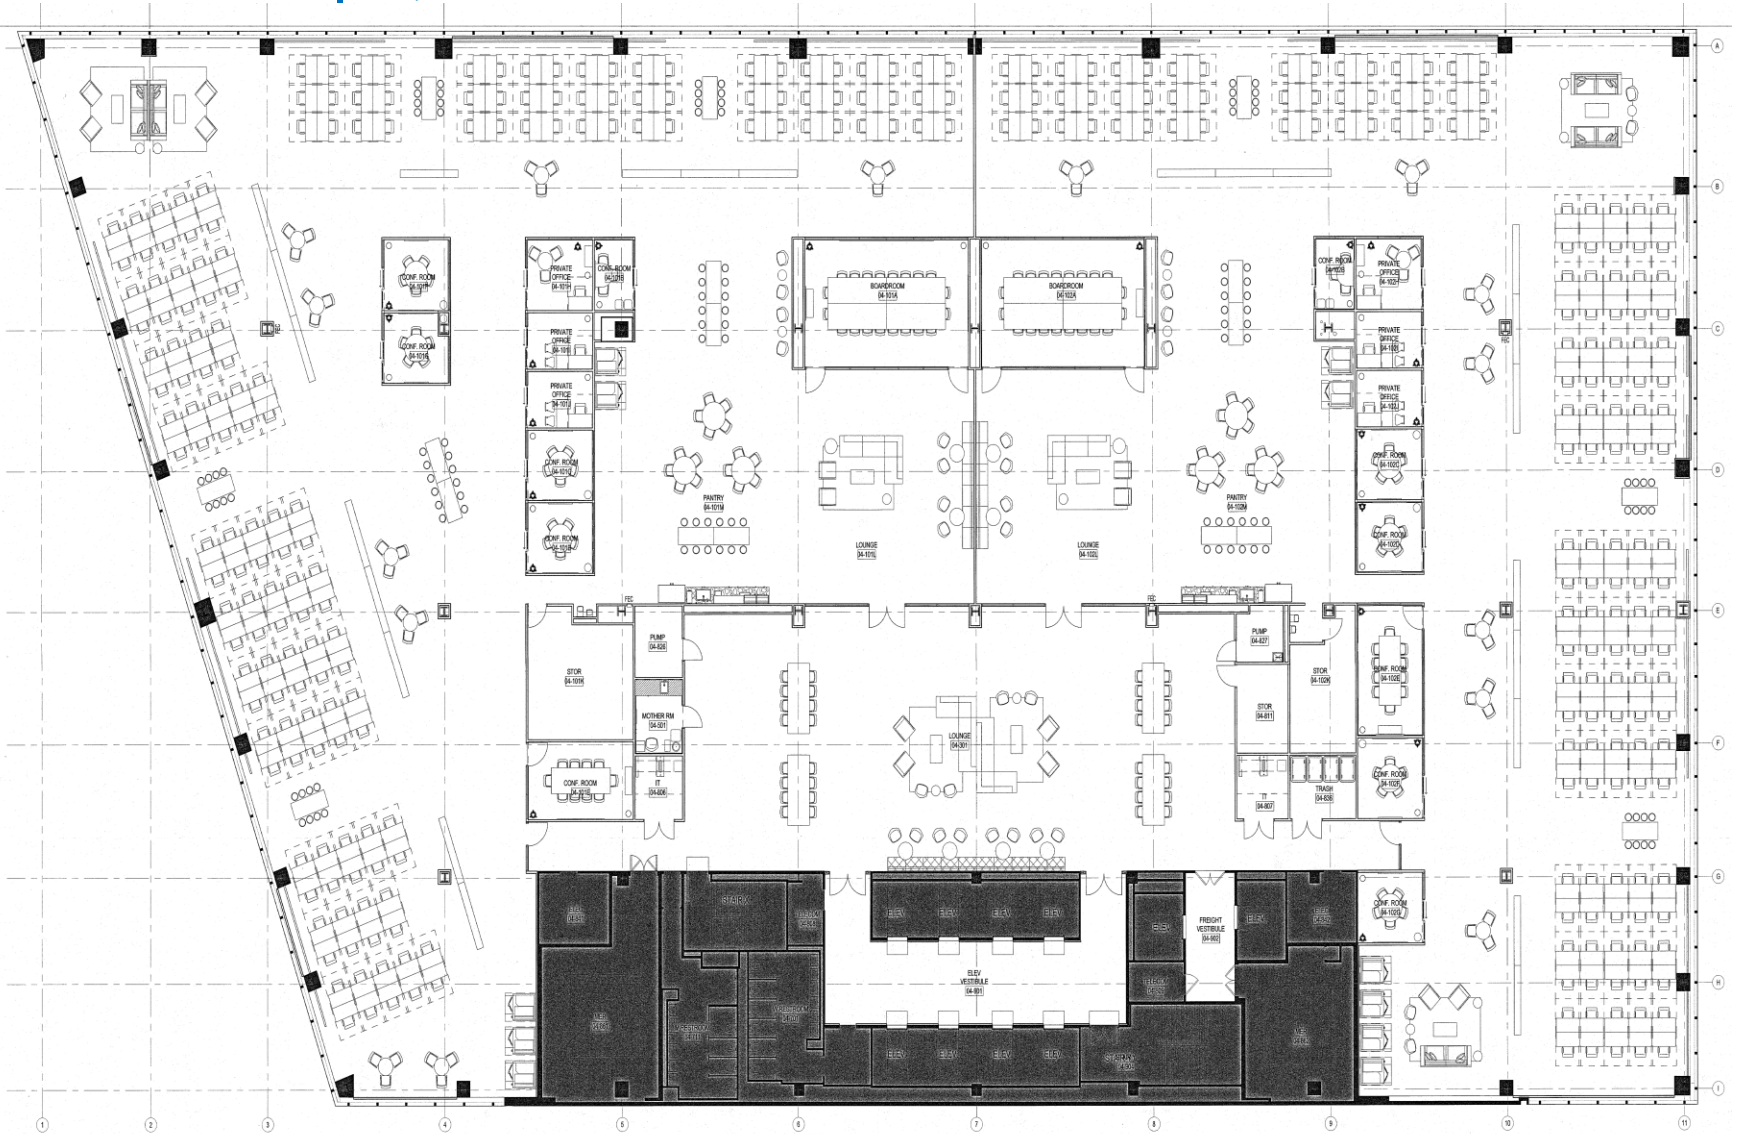

Jack Resnick & Sons  
Owners & Builders Since 1928