


110 EAST 59 STREET

PLAZA DISTRICT

Entire 27th Floor | As-Built | 13,284 SF

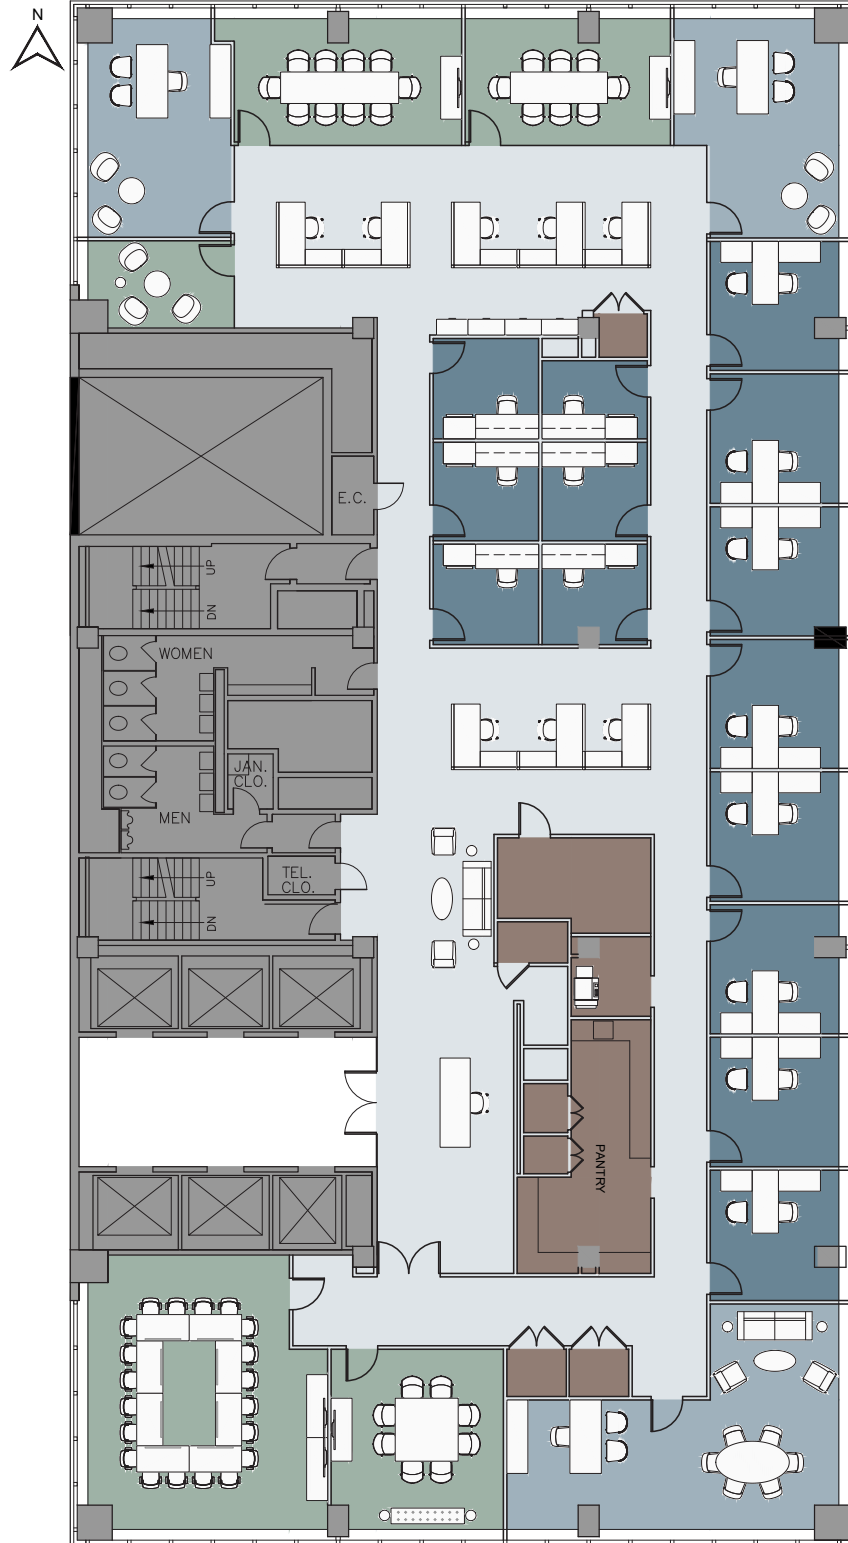

LEGEND

WORKSPACE		PRGM
● EXECUTIVE OFFICE	3	
● PRIVATE OFFICE	14	
● WORKSTATION	8	
TOTAL HEADCOUNT		25
COLLABORATIVE SPACE		
● CONFERENCE	4	
● PHONE ROOM	1	
SUPPORT		
● PANTRY	1	
● COAT CLOSET	-	
● STORAGE	-	
● COPY	1	

JR Jack Resnick & Sons
Owners & Builders Since 1928

110 East 59 Street
New York, NY 10022-1379
resnicknyc.com

Fran Delgorio
646.253.3100
fdelgorio@resnicknyc.com

Brett S. Greenberg
646.253.3113
bgreenberg@resnicknyc.com



No warranty or representation, express or implied, is made as to the accuracy of the information contained herein, and same is submitted subject to errors, omissions, change of price, rental other conditions, withdrawal without notice, and to any special listing conditions, imposed by our principals.