




5th Floor | As-Built | 27,780 RSF

DOMINICK STREET

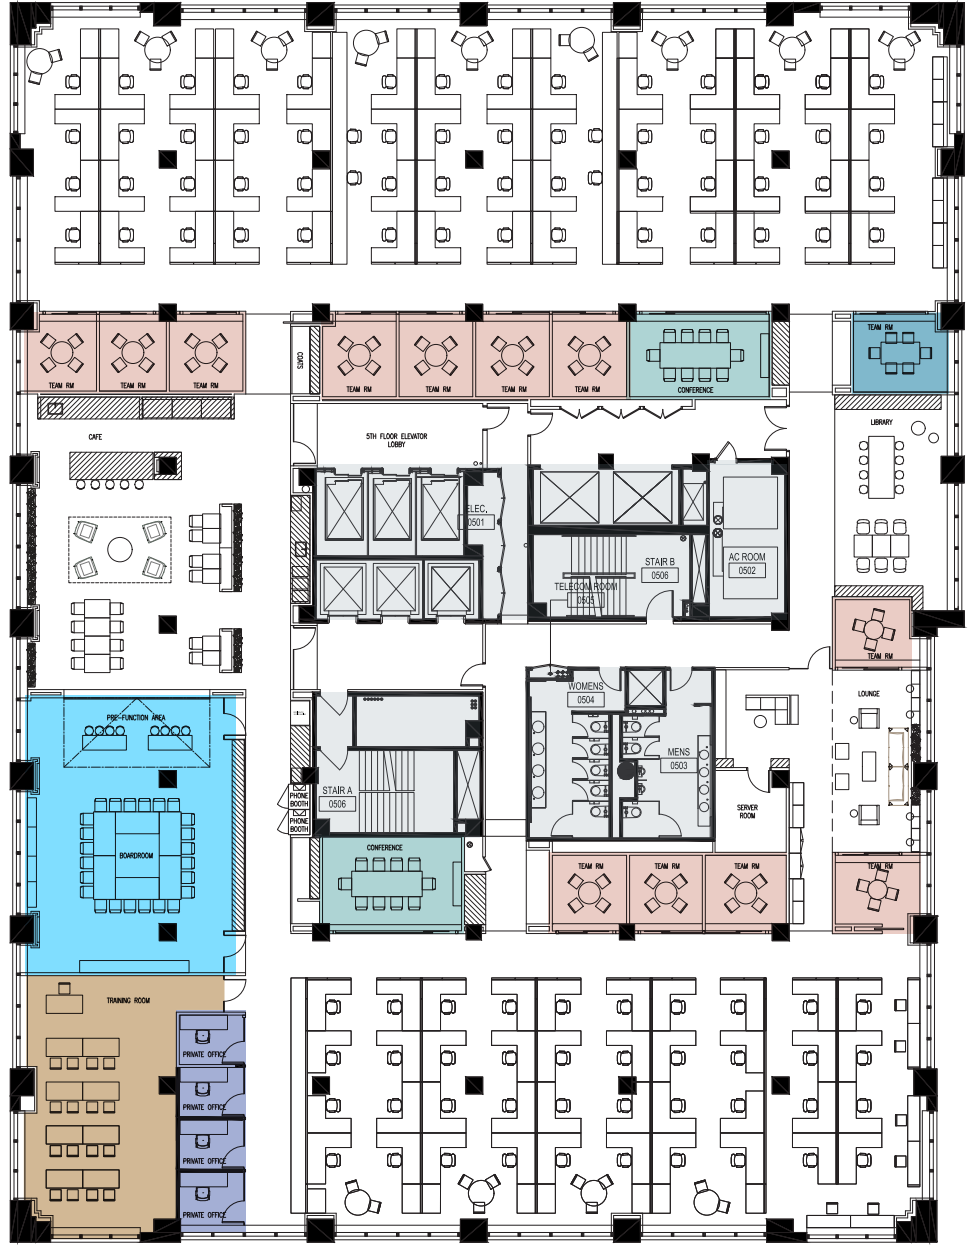

HUDSON STREET

BROOME STREET



WORKSPACE

Workstations	96
Private Offices	4
TOTAL	100

MEET

Conference/Meeting Rooms	17
--------------------------	----

SOCIAL

Pantry	1
Lounge	1
Wellness Room	1
Phone Room	1

Adam S. Rappaport Managing Director
646.253.3111 / arappaport@resnicknyc.com

Brett S. Greenberg Executive Managing Director
646.253.3113 / bgreenberg@resnicknyc.com

250hudson.nyc

