


8 WEST 40 STREET

BRYANT PARK DISTRICT

Entire 10th Floor | As-Built | 6,667 SF

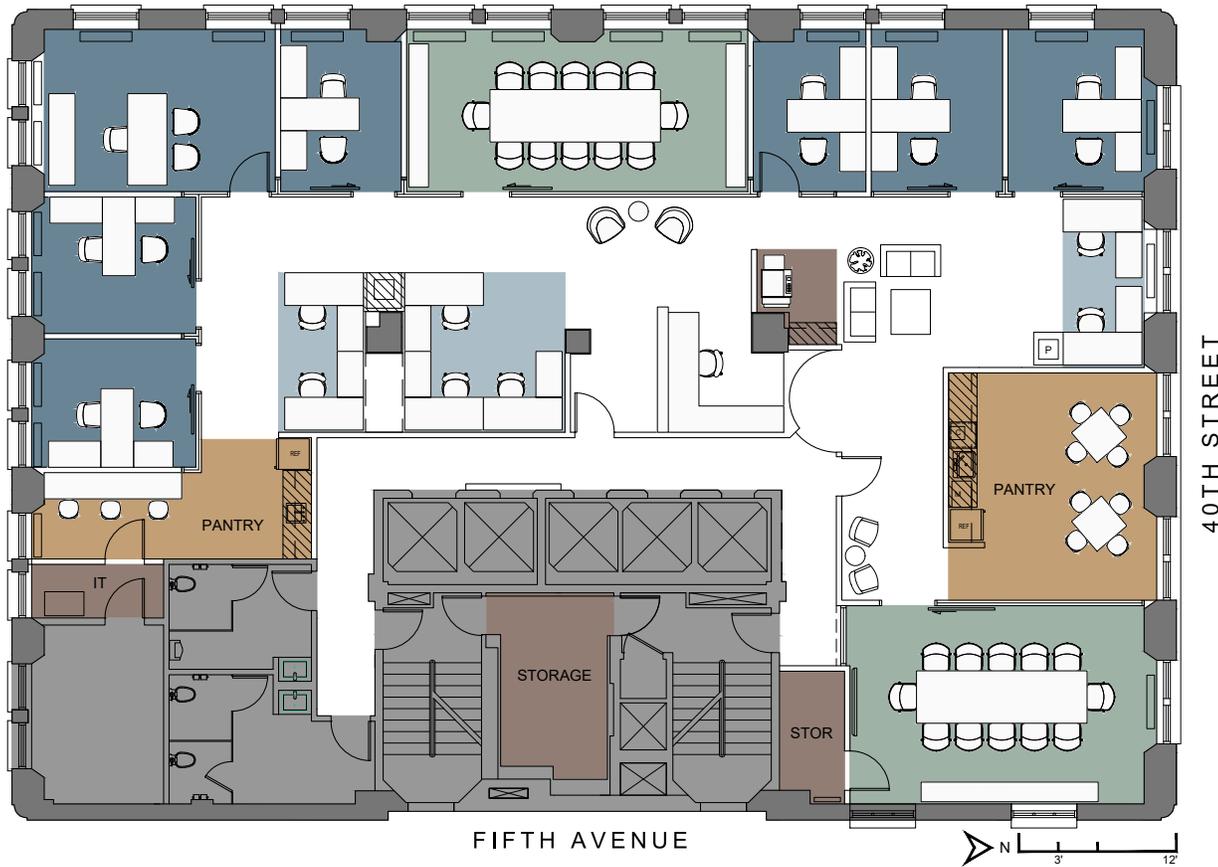

LEGEND

WORKSPACE	SEATS
EXECUTIVE OFFICE	1
PRIVATE OFFICE	6
WORKSTATION (6'x6')	7
RECEPTION	1
TOTAL HEADCOUNT	14

COLLAB SPACE	QNTY
12P CONFERENCE	2
OPEN MEETING	2

SUPPORT	QNTY
PANTRY	2
COPY AREA	1
IT ROOM	1
STORAGE	2

SUGGESTED FURNITURE LAYOUT

AS BUILT PLAN

JP Jack Resnick & Sons
Owners & Builders Since 1928

110 East 59 Street
New York, NY 10022-1379
resnicknyc.com

Fran Delgorio
646.253.3100
fdelgorio@resnicknyc.com

Brett S. Greenberg
646.253.3113
bgreenberg@resnicknyc.com



No warranty or representation, express or implied, is made as to the accuracy of the information contained herein, and same is submitted subject to errors, omissions, change of price, rental other conditions, withdrawal without notice, and to any special listing conditions, imposed by our principals.