

AS-BUILT: FULL FLOOR 9

9,577 SF

Fully Furnished and Wired

[View 3D Tour](#) 

Work Place

Offices	4
Workstations (6' x 5')	90


Meet

Conference Rooms	4
------------------	---

Social

Reception	1
Pantry	1

Total Desks 94

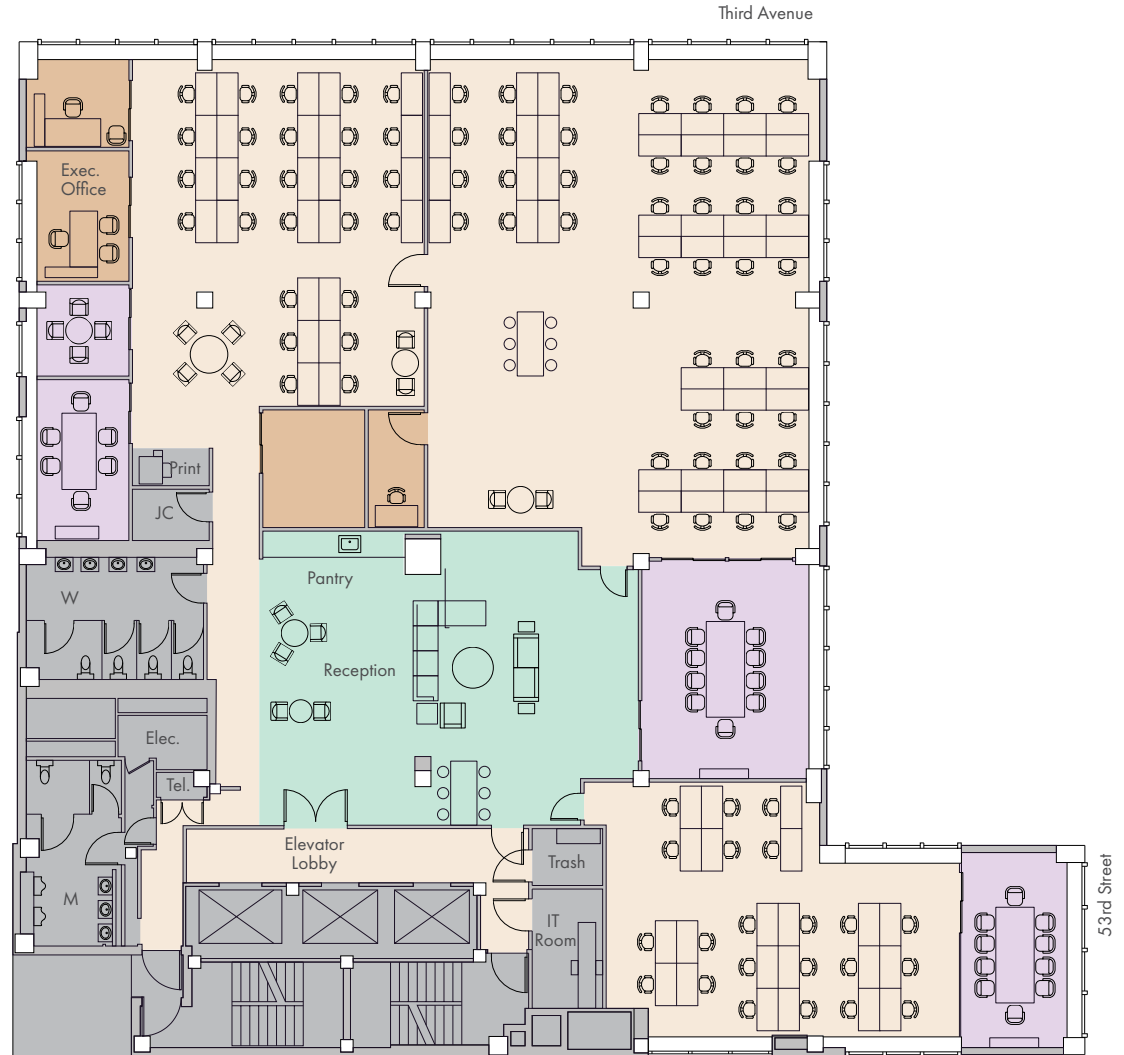

880
THIRD AVENUE


Jack Resnick & Sons
Owners & Builders Since 1928

Adam Rappaport
arappaport@resnicknyc.com
646.253.3111

Brett S. Greenberg
bgreenberg@resnicknyc.com
646.253.3113

880third.nyc

