
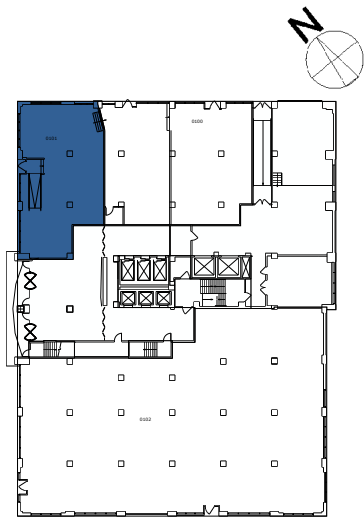


250 HUDSON STREET

Retail | As-Built | 2,314 SF

HUDSON SQUARE DISTRICT

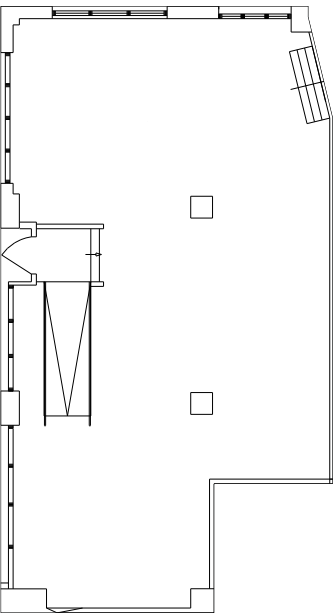

Key Plan - Not to scale



Jack Resnick & Sons

Owners & Builders Since 1928

110 East 59 Street

New York, NY 10022-1379

resnicknyc.com

Adam S. Rappaport

646.253.3111

arappaport@resnicknyc.com

Brett S. Greenberg

646.253.3113

bgreenberg@resnicknyc.com





No warranty or representation, express or implied, is made as to the accuracy of the information contained herein, and same is submitted subject to errors, omissions, change of price, rental other conditions, withdrawal without notice, and to any special listing conditions, imposed by our principals.

250 HUDSON STREET

Retail | As-Built | 1,387 SF

HUDSON SQUARE DISTRICT

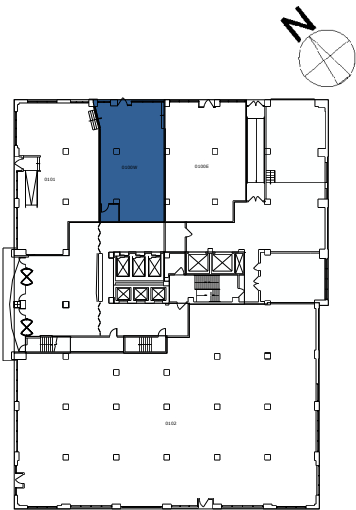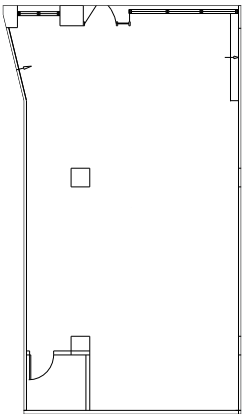

Key Plan - Not to scale



Jack Resnick & Sons

Owners & Builders Since 1928

110 East 59 Street
New York, NY 10022-1379
resnicknyc.com

Adam S. Rappaport
646.253.3111
arappaport@resnicknyc.com

Brett S. Greenberg
646.253.3113
bgreenberg@resnicknyc.com





No warranty or representation, express or implied, is made as to the accuracy of the information contained herein, and same is submitted subject to errors, omissions, change of price, rental other conditions, withdrawal without notice, and to any special listing conditions, imposed by our principals.

250 HUDSON STREET

Retail | As-Built | 1,713 SF

HUDSON SQUARE DISTRICT

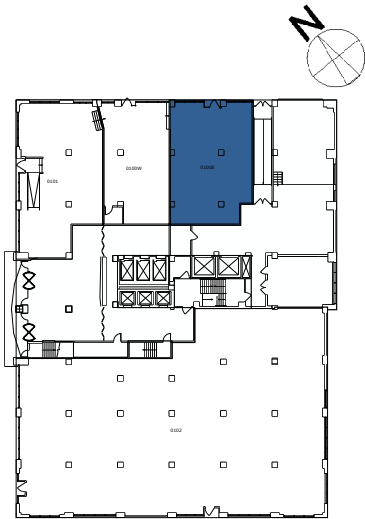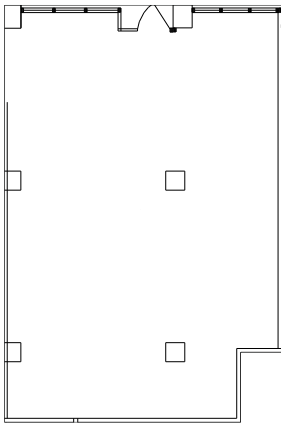

Key Plan - Not to scale

JP Jack Resnick & Sons
Owners & Builders Since 1928

110 East 59 Street
New York, NY 10022-1379
resnicknyc.com

Adam S. Rappaport
646.253.3111
arappaport@resnicknyc.com

Brett S. Greenberg
646.253.3113
bgreenberg@resnicknyc.com



No warranty or representation, express or implied, is made as to the accuracy of the information contained herein, and same is submitted subject to errors, omissions, change of price, rental other conditions, withdrawal without notice, and to any special listing conditions, imposed by our principals.

250 HUDSON STREET

RETAIL | SHOWROOM | OFFICE



Jack Resnick & Sons
Owners & Builders Since 1928



resnicknyc.com
250hudson.nyc


Brett S. Greenberg
646.253.3113
bgreenberg@resnicknyc.com

Adam Rappaport
646.253.3111
arappaport@resnicknyc.com

RETAIL | SHOWROOM | OFFICE

Corner of Hudson & Dominick Streets

VIEW 3D TOUR

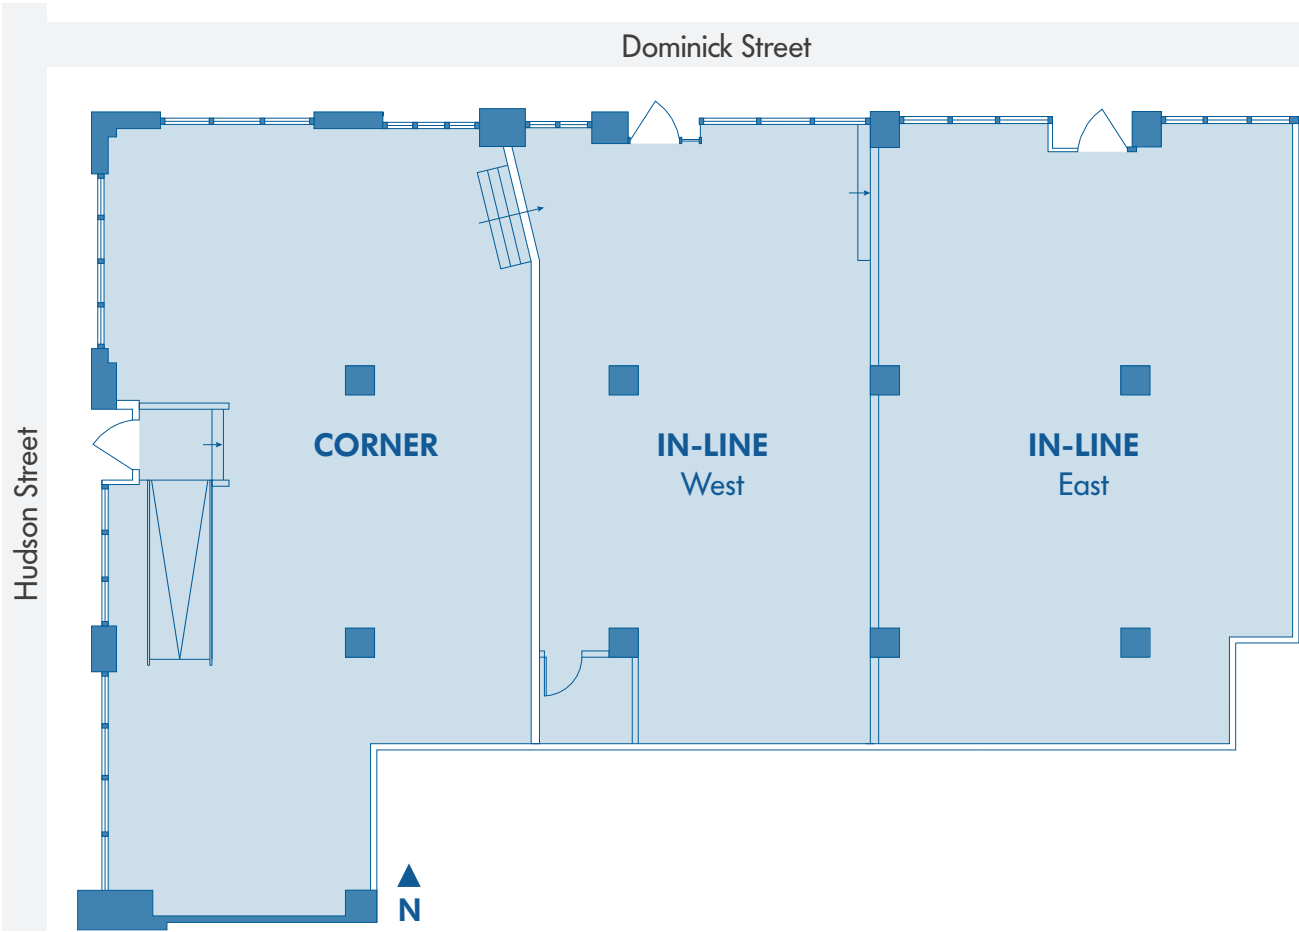

ENTIRE SPACE

Ground Level	5,414 SF
Lower Level	1,225 SF
Wraparound Frontage	159'

CORNER

Ground Level	2,314 SF
Lower Level	1,225 SF
Frontage	96'
Ceiling Height	19'

IN-LINE

*Divisions possible

Ground Level*	3,100 SF
West*	1,387 SF
East*	1,713 SF
Frontage	63'
Ceiling Height	16'

EXPERIENCE THE TRANSFORMATION

In the Vibrant Hudson Square

Hudson Square has undergone a remarkable transformation, evolving from its industrial roots into a vibrant and dynamic neighborhood. With revitalized streetscapes, improved public spaces, and a growing sense of community, Hudson Square has emerged as a sought-after destination for living, working, and leisure.

Corporate giants setting roots

Google's redevelopment at St. John's Terminal & 315 Hudson and Disney's new headquarters adds 13,000 employees to the 130,000 working within a 1/4 mile.

Growing pedestrian population

Hudson Square receives 36,000+ pedestrians a day, reinforcing its status as a thriving community and business hub

Convenient transportation

Short walk to 1 A C E subway lines

Adam Rappaport
646.253.3111
arappaport@resnicknyc.com

Brett S. Greenberg
646.253.3113
bgreenberg@resnicknyc.com

 Jack Resnick & Sons
Owners & Builders Since 1928

