




# 4th Floor | As-Built | 27,780 RSF

DOMINICK STREET

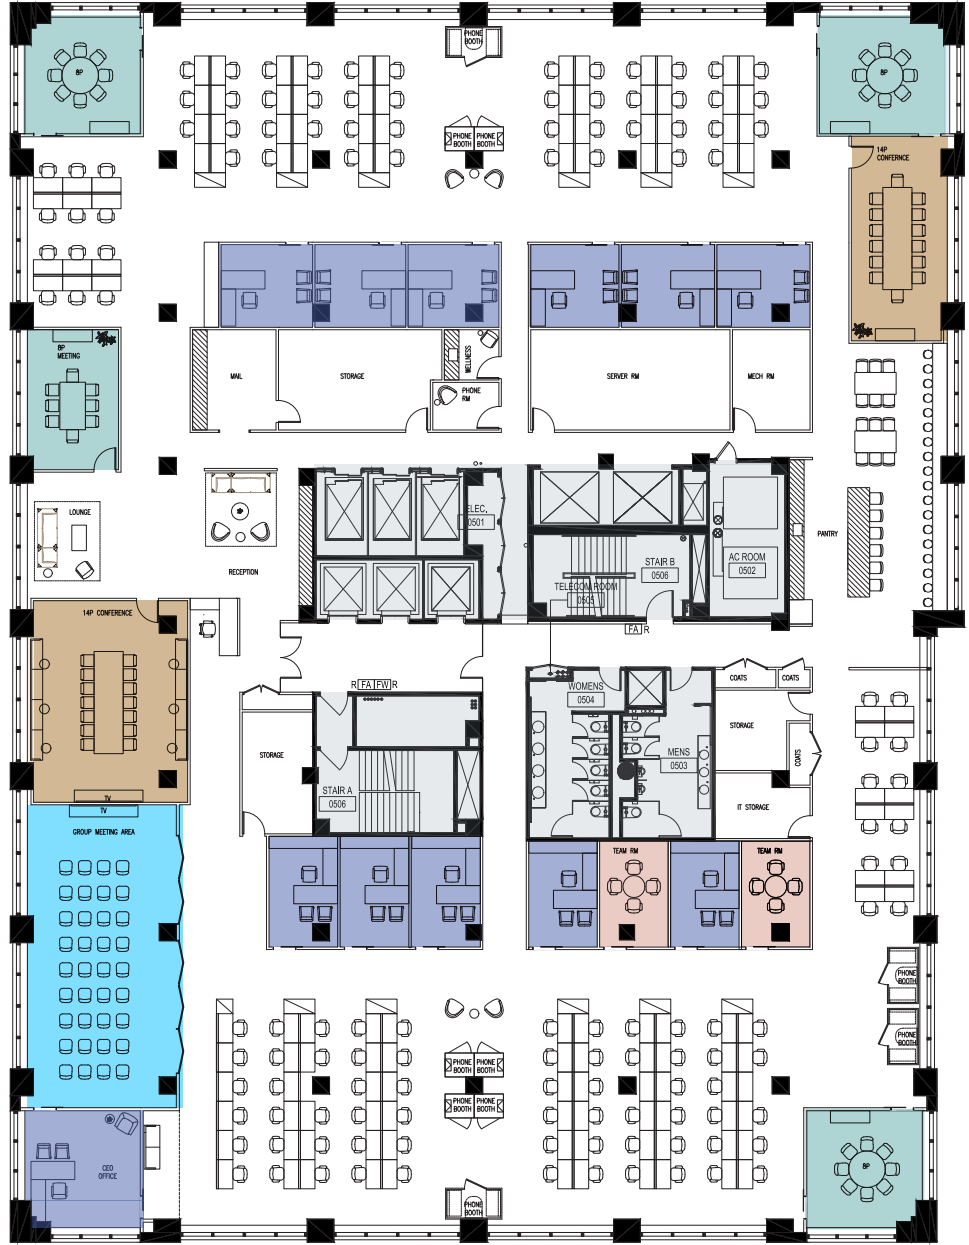

HUDSON STREET

BROOME STREET

### WORKSPACE

Workstations	131
Private Offices	12
<b>TOTAL</b>	<b>143</b>

### MEET

Conference/Meeting Rooms	9
--------------------------	---

### SOCIAL

Pantry	1
Lounge	1
Wellness Room	1
Phone Room	1

Adam S. Rappaport Managing Director  
646.253.3111 / arappaport@resnicknyc.com

Brett S. Greenberg Executive Managing Director  
646.253.3113 / bgreenberg@resnicknyc.com

250hudson.nyc

