


8 WEST 40 STREET

Entire 16th Floor | AS-Built | 6,667 SF

BRYANT PARK DISTRICT

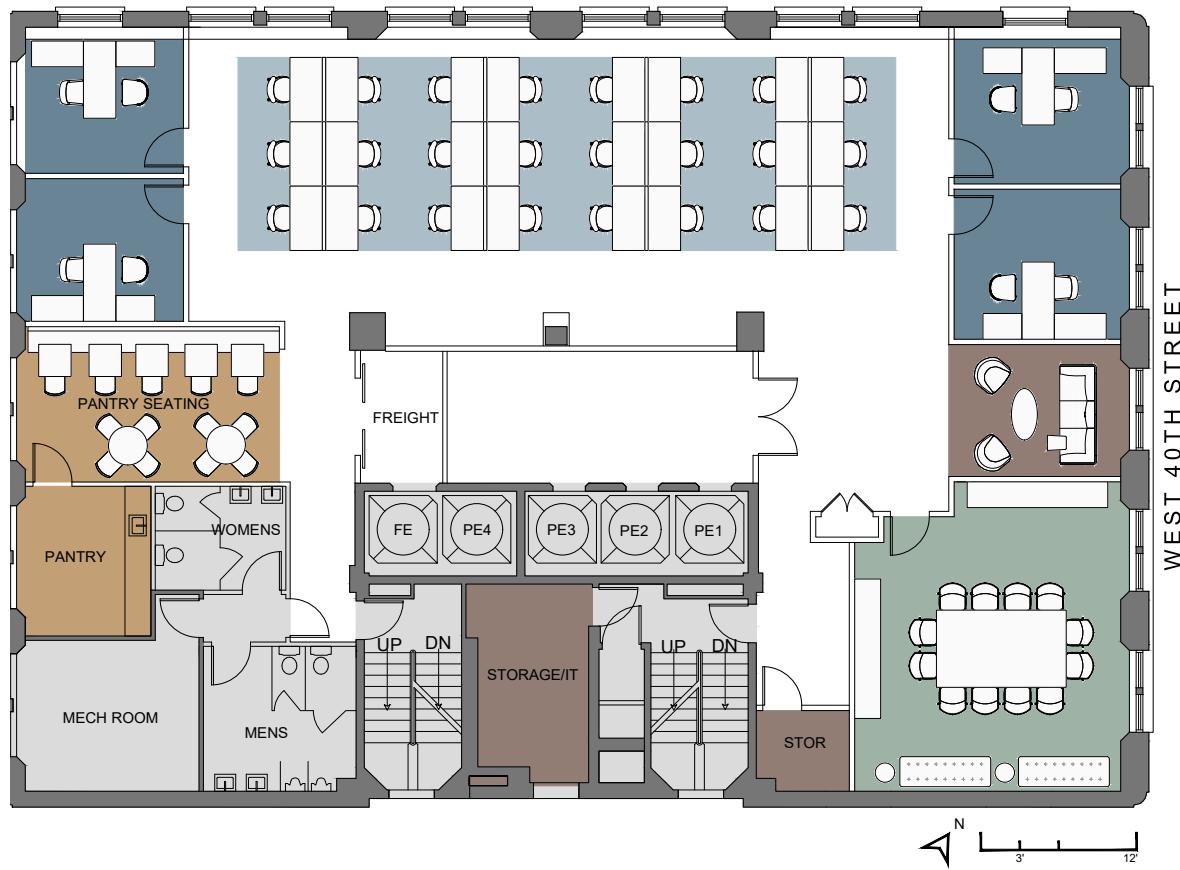

Jack Resnick & Sons
Owners & Builders Since 1928



110 East 59 Street
New York, NY 10022-1379
resnicknyc.com

Fran Delgorio
646.253.3100
fdelgorio@resnicknyc.com

Brett S. Greenberg
646.253.3113
bgreenberg@resnicknyc.com

No warranty or representation, express or implied, is made as to the accuracy of the information contained herein, and same is submitted subject to errors, omissions, change of price, rental other conditions, withdrawal without notice, and to any special listing conditions, imposed by our principals.