


# 8 WEST 40 STREET

# BRYANT PARK DISTRICT


Entire 18th Floor | AS-Built | 6,667 SF

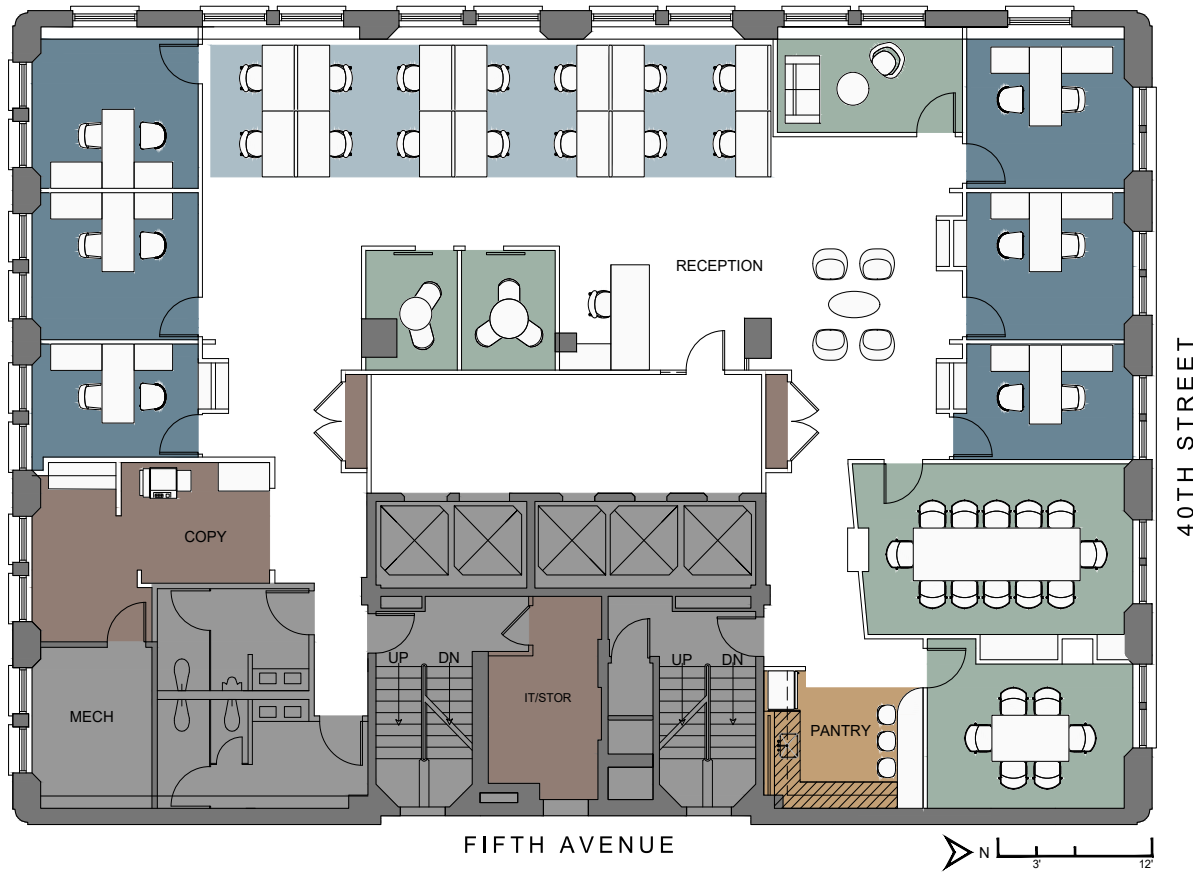

LEGEND	
<b>WORKSPACE</b>	<b>SEATS</b>
PRIVATE OFFICE	6
BENCHING (5'X30")	14
RECEPTION	1
<b>TOTAL HEADCOUNT</b>	<b>21</b>
<b>COLLAB SPACE</b>	<b>QNTY</b>
12P CONFERENCE	1
6P CONFERENCE	1
2-3P MEETING	2
INFORMAL MEETING	1
<b>SUPPORT</b>	<b>QNTY</b>
PANTRY	1
COAT CLOSET	2
COPY AREA	1
IT/STORAGE ROOM	2

FIFTH AVENUE

40TH STREET

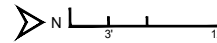

18TH FLOOR

AS BUILT PLAN

**JP** Jack Resnick & Sons  
Owners & Builders Since 1928

110 East 59 Street  
New York, NY 10022-1379  
resnicknyc.com

**Fran Delgorio**  
646.253.3100  
fdelgorio@resnicknyc.com

**Brett S. Greenberg**  
646.253.3113  
bgreenberg@resnicknyc.com



No warranty or representation, express or implied, is made as to the accuracy of the information contained herein, and same is submitted subject to errors, omissions, change of price, rental other conditions, withdrawal without notice, and to any special listing conditions, imposed by our principals.